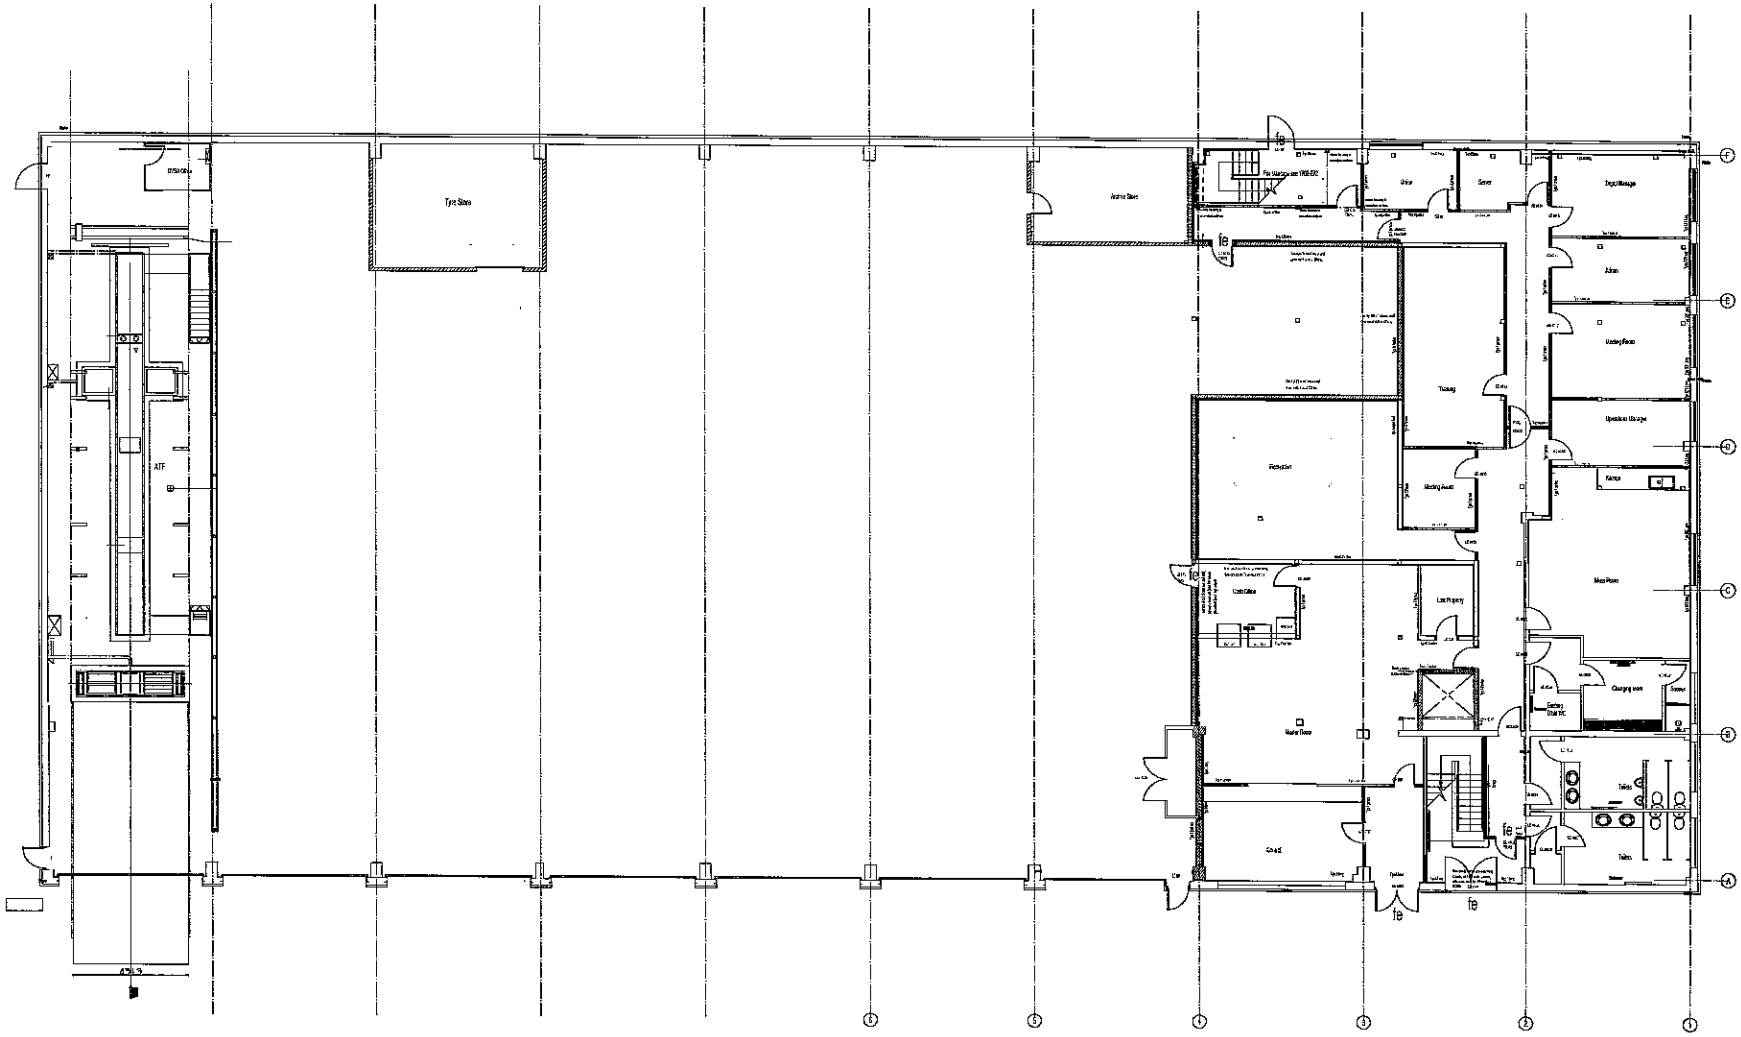

NOTE

Type A
Fire Resist Stud Partition

Fire door to be 30 minutes with 10mm Pyrostop intumescent Cassette @ 600 c/c with 25mm intumescent strip and smoke seal within casing.
Finish - Type as plan.

Type B

Fire door to be 30 minutes with 10mm Pyrostop intumescent Cassette @ 600 c/c with 25mm intumescent strip and smoke seal within casing, 30mm polycarbonate vision panel, 30mm intumescent FR Rockwool infill, self closer.
Finish - Type as plan to match adjacent door to Stores.

All doors to be fitted with SIGNCHECK

Type C

Fire door to be 30 minutes with 10mm Pyrostop intumescent Cassette @ 600 c/c.
Finish - Type as plan















60mins FR

30mins FR

No.	Date	Revision	Initial
A	05/03/18	AS BUILT. Based on info issued by STP 31/05/17	cdw

bwd
Architects and Surveyors

9 Red Lion Lane
Newbold Verdon
Leicestershire
LE9 9LS
Tel/Fax 01455 251 157

Project

Proposed Bus Depot
Unit 10 & 11
Kingstanding Way
Tonbridge Wells, TN2 3UP

Client

ARRIVA

Drawing

Unit 10
Ground Floor Fire Strategy

Scale 1:50 @ A1 1:100 @ A3 | Date March 2017

Drawn cdw | Checked -

Drawing No

1702 - 105A

This drawing and design is the copyright of burgoine williams design limited and must not be reproduced in part or in whole without the prior written permission of a Director of burgoine williams design limited.
Contractors must verify all dimensions on site prior to commencing work or preparing fabrication drawings.

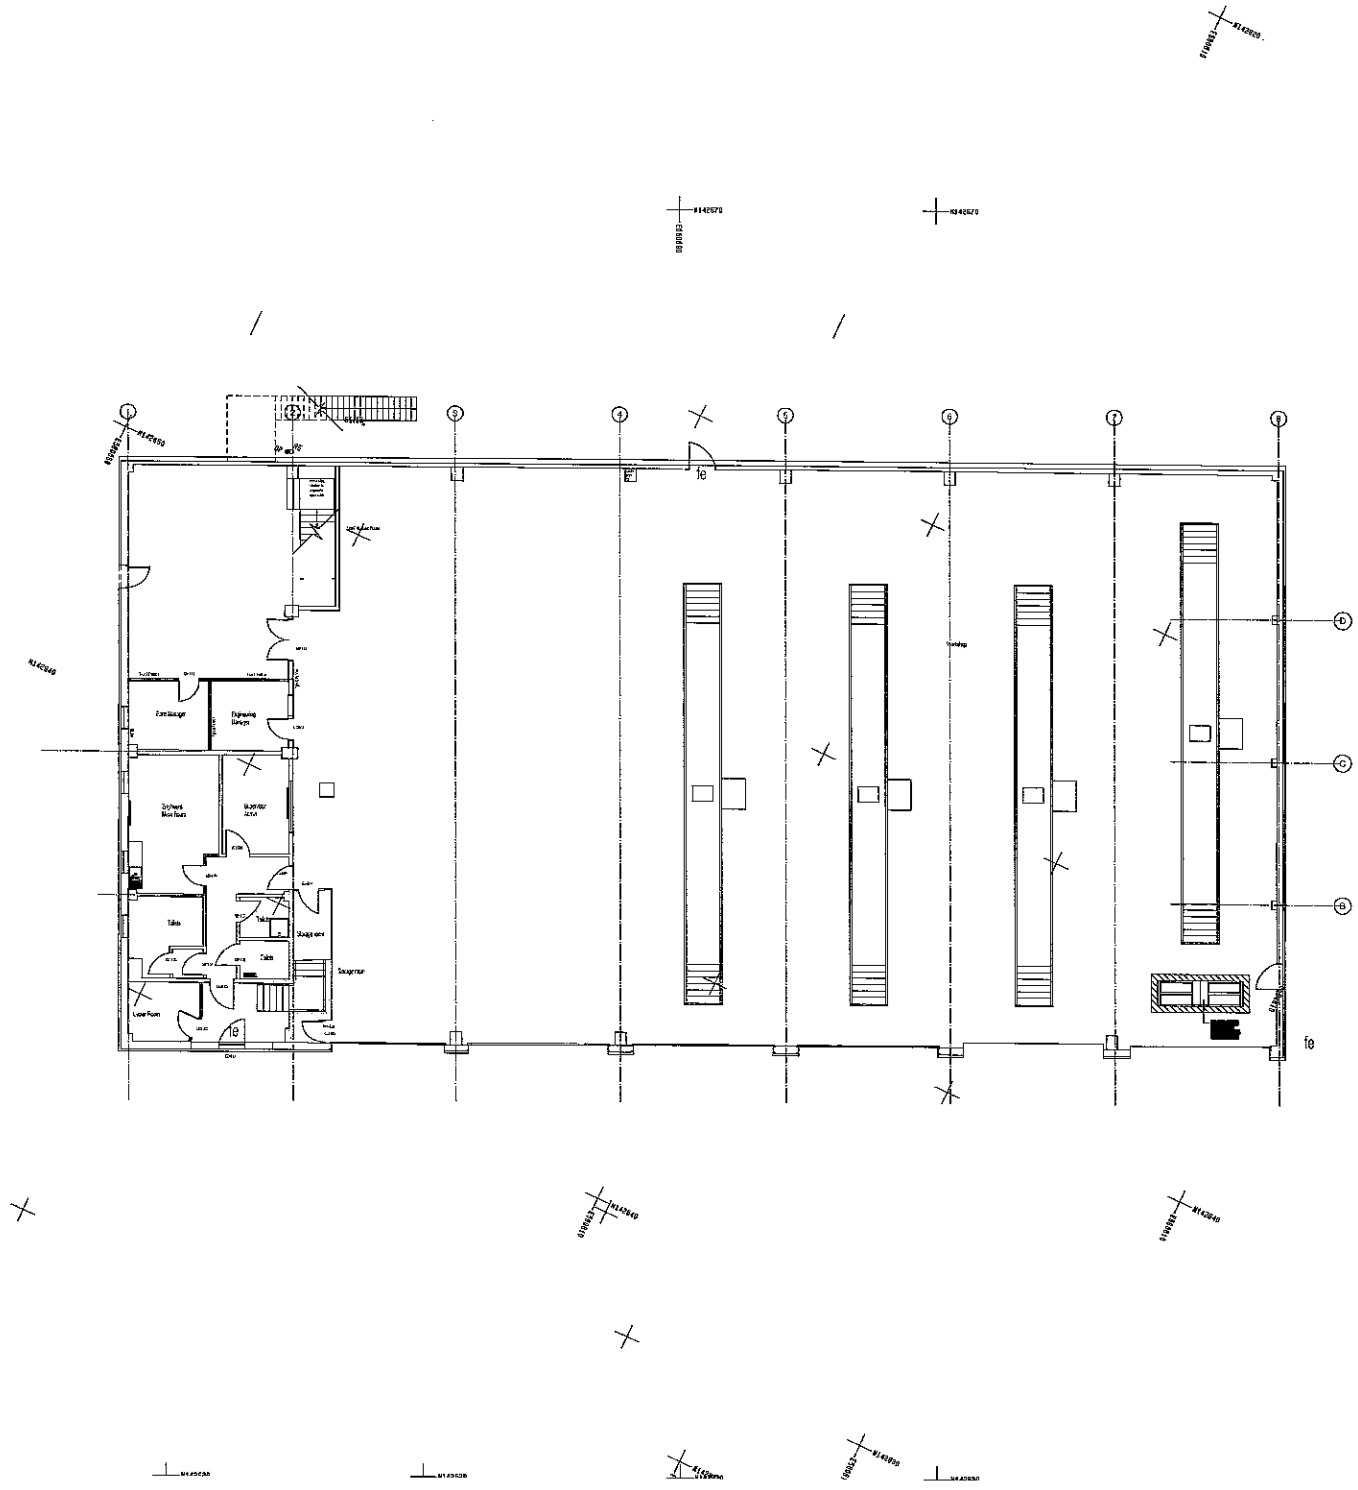

Subject to Building Control and Fire Officer Approval

No	Date	Revision	Initial
A	04/07/16	AS BUILT. Taken from info provided by STP 24/05/16	cdw

bwd
Architects and Surveyors

9 Red Lion Lane
Newbold Verdon
Leicestershire
LE9 9LS
Tel/FAX 01 455 251 157

Project

Proposed Bus Depot
Unit 10 & 11
Kingstanding Way
Tonbridge Wells, TN2 3UP

Client

ARRIVA

Drawing

Unit 11
Ground Floor Fire Regime Sht 02

Scale 1:50 @ A1
1:100 @ A3

Date June 2017

Drawn cdw

Checked -

Drawing No

1702 - 311A

This drawing and design is the copyright of burgoine williams design limited and must not be reproduced in part or in whole without the prior written permission of a Director of burgoine williams design limited.
Contractors must verify all dimensions on site prior to commencing work or preparing fabrication drawings.